












Date: Monday, 3/13/2006 10:01:23 AM
 User: Linda Lacelle

Process Sheet

Customer	: CU-DAR001 Dart Helicopters Services	Drawing Name	: STEM
Job Number	: 26210A		
Estimate Number	: 10394		
P.O. Number	: N/A	Part Number	: D29681
This Issue	: 3/13/2006 S.O. No. : N/A	Drawing Number	: D2968 UNDER-REVIEW OK 06.03.15
Prsht Rev.	: NC	Project Number	: N/A
First Issue	: 3/13/2006 Type : MACHINED PARTS	Drawing Revision	: B1
Previous Run	: 24537A	Material	: N/A
Written By	: <u>SEE COMMENT BELOW</u>	Due Date	: 4/10/2006
Checked & Approved By	: <u>SEE ABOVE USER & DATE</u>	Qty:	42 Um: Each
Comment	: Est:C 03.04.11 Reformat; Incorporated D2968-1/5 KJ/RF		
Additional Product			
Job Number: 			
Seq. #:	Machine Or Operation:	Description :	
1.0	M4130NR0750	4130 steel rod .750"	
			
Comment: Qty.: 0.4550 f(s)/Unit Total : 18.1986 f(s) Material: AISI 4130 Ø 3/4 " Bar (M4130N-R0.750) Batch: <u>M19162</u> Identify AS D2968-1			
2.0	HARDINGE	HARDINGE CNC LATHE SMALL	
			
Comment: HARDINGE CNC LATHE SMALL 1-Turn Blank as per Folio FA047 and Dwg D2968 <u>M8 06/03/20</u> 2-Deburr, no sharp edges			
3.0	QC2	INSPECT PARTS AS THEY COME OFF MACHINE	
			
Comment: INSPECT PARTS AS THEY COME OFF MACHINE <u>M8 06/03/20</u>			
4.0	HAAS1	HAAS CNC VERTICAL MACHINING #1	
			
Comment: HAAS CNC VERTICAL MACHINING #1 1- Machine as per Folio FA047 and Dwg D2968 2- Deburr <u>J.F. 06/04/18</u>			
5.0	QC2	INSPECT PARTS AS THEY COME OFF MACHINE	
			
Comment: INSPECT PARTS AS THEY COME OFF MACHINE <u>J.F. 06/04/18</u>			

W/O:		WORK ORDER CHANGES					
DATE	STEP	PROCEDURE CHANGE	By	Date	Qty	Approval Chief Eng / Prod Mgr	Approval QC Inspector

Part No: _____ PAR #: _____ Fault Category: _____ NCR: Yes ☒ No ☐ DQA: ☒ Date: 06/04/19
 QA: N/C Closed: _____ Date: _____

NCR:		WORK ORDER NON-CONFORMANCE (NCR)						
DATE	STEP	Description of NC Section A	Corrective Action Section B			Verification Section C	Approval Chief Eng	Approval QC Inspector
			Initial Chief Eng	Action Description Chief Eng	Sign & Date			

NOTE: Date & initial all entries

Process Sheet

Customer: CU-DAR001 Dart Helicopters Services

Drawing Name: STEM

Job Number: 26210A

Part Number: D29681

Job Number:



Seq. #:

Machine Or Operation:

Description :

6.0

QC8

SECOND CHECK



Comment: SECOND CHECK

SA 06.04.18

7.0

PACKAGING 1

PACKAGING RESOURCE #1



Comment: PACKAGING RESOURCE #1

Identify and Stock

Location: _____

SA 06/04/19
42

8.0

DC

DOCUMENT CONTROL



Comment: DOCUMENT CONTROL

Inspection Level 21

SA 06/04/19
42

Job Completion



u 06.04.19

W/O:		WORK ORDER CHANGES					
DATE	STEP	PROCEDURE CHANGE	By	Date	Qty	Approval Chief Eng / Prod Mgr	Approval QC Inspector

Part No: _____ PAR #: _____ Fault Category: _____ NCR: Yes No DQA: _____ Date: _____

QA: N/C Closed: _____ Date: _____

NCR:		WORK ORDER NON-CONFORMANCE (NCR)						
DATE	STEP	Description of NC Section A	Corrective Action Section B			Verification Section C	Approval Chief Eng	Approval QC Inspector
			Initial Chief Eng	Action Description Chief Eng	Sign & Date			

NOTE: Date & initial all entries

DART AEROSPACE LTD		Work Order:	26210A
Description: Stem		Part Number:	D2968-1
Inspection Dwg: D2968 Rev: B1		Page 1 of 1	

FIRST ARTICLE INSPECTION CHECKLIST

☒ First Article ☐ Prototype


Drawing Dimension	Tolerance	Actual Dimension	Accept	Reject	Method of Inspection	Comments
5.040	+/-0.010	5.044	✓			
4.020	+0.000/-0.010	4.017	✓			
3.270	+/-0.010	3.270	✓			
0.470	+/-0.010	.470	✓			
0.250	+/-0.010	.248	✓			
0.550	+/-0.010	.557	✓			
Ø0.750	+/-0.010	.747	✓			
Ø0.625	+/-0.010	.622	✓			
Ø0.363	+/-0.010	Ø.363				
0.250	+0.010/-0.000	.252"				
0.625	+/-0.010	.627"				
0.150	+/-0.010	.144"				
0.250	+0.010/-0.000					
0.625	+/-0.010					
0.150	+/-0.010					
1/4-28 Major dia	0.243 - 0.249					
MOW	0.261 - 0.267	.266	✓			

HAAS

Measured by: MS	Audited by: SA	Prototype Approval:	N/A
Date: 06/03/20	Date: 06.04.18	Date:	N/A

Rev	Date	Change	Revised by	Approved
A	04.02.25	New Issue P/O D2968-041	KJ/RF	
B	05.05.26	Dimensions added	KJ/JLM	

RELEASED

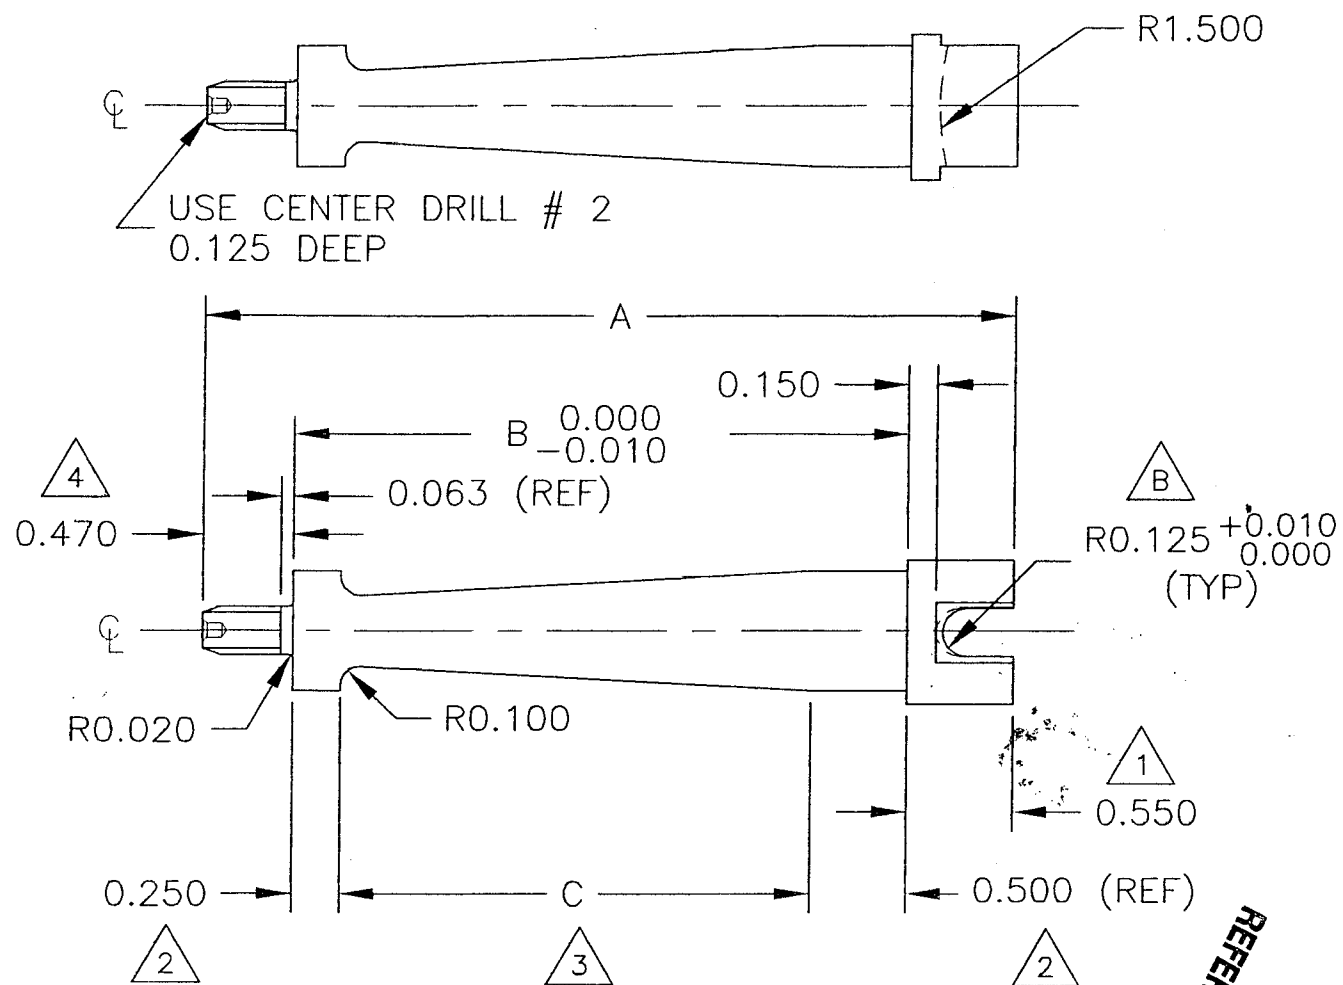

PART NUMBER	A	B	C
D2968-1	5.040	4.020	3.270
D2968-3	4.200	3.180	2.430

D2968-1/-3 STEM

D2968-1 AND D2968-3 STEM:

MATERIAL: AISI 4130

1 $\phi 0.750$ O.D.

2 $\phi 0.625$ O.D.


3 MACHINE UNIFORM TAPER FROM $\phi 0.363$ O.D. TO $\phi 0.625$ O.D.

4 1/4-28 UNF THREAD WITH 0.063 GRIP MACHINE ALL INSIDE EDGES WITH A 0.010 RADIUS UNLESS OTHERWISE INDICATED TOLERANCES ARE PER DART QSI 018 UNLESS OTHERWISE NOTED

D2968-5 RING:

MATERIAL AISI 4130

TOLERANCES ARE PER DART QSI 018 UNLESS OTHERWISE NOTED

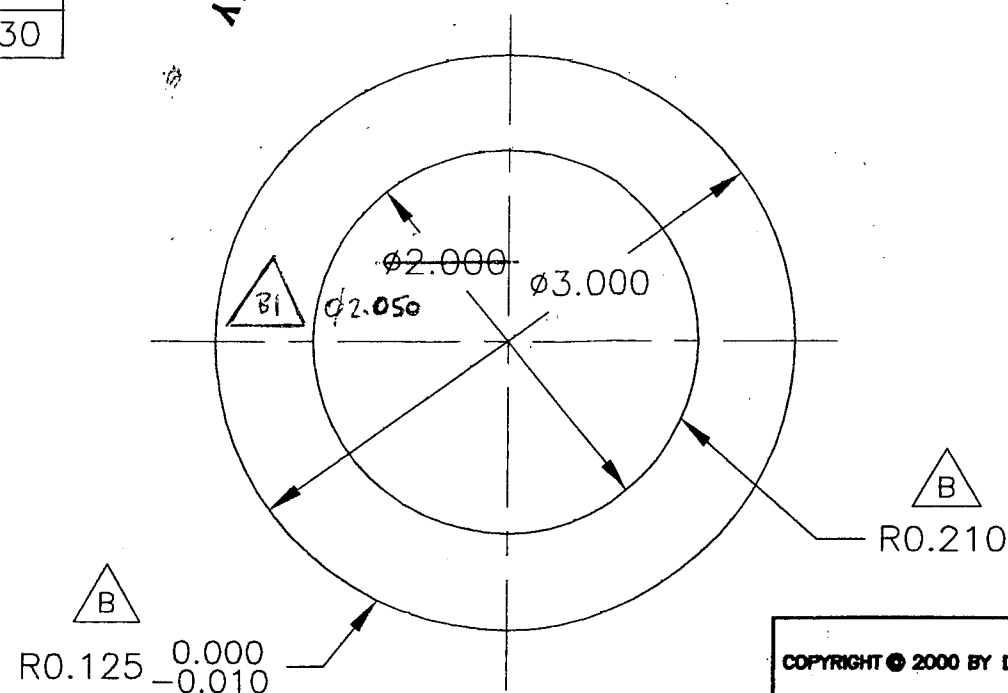

D2968-5 RING

D2968-5 RING

1/8

RELEASED
00.06.09

UNDER REVIEW

USE 2968-1 STEM FOR -041
USE 2968-3 STEM FOR -043

D2968-041 AND D2968-043 TOW RING:

WELD PER QSI 004 ON ALL EDGES BETWEEN STEM AND RING
HEAT TREAT TO MIN ULTIMATE TENSILE STRENGTH OF 125 KSI
FINISH: CAD PLATE ENTIRE ASSEMBLY PER

QQ-P-416F CLASS I TYPE II

POWDER COAT WHITE (REF 4.3.5.2) PER DART

QSI 005 4.3 (EXCEPT THREADS)

TOLERANCES ARE PER DART QSI 018 UNLESS OTHERWISE NOTED

B	00.05.31	R0.125 AND R0.210 WERE 0.060 x 45°
A	00.03.07	NEW ISSUE
DESIGN	DRAWN BY	DART DART AEROSPACE LTD. HAWKESBURY, ONTARIO, CANADA
CHECKED	APPROVED	DRAWING NO. D2968 REV. B SHEET 1-OF 1
DATE	00.05.31	TITLE TOW RING SCALE 1:1

COPYRIGHT © 2000 BY DART AEROSPACE LTD.

THIS DOCUMENT IS PRIVATE AND CONFIDENTIAL AND IS SUPPLIED ON THE EXPRESS CONDITION THAT IT IS NOT TO BE USED FOR ANY PURPOSE OR COPIED OR COMMUNICATED TO ANY OTHER PERSON WITHOUT WRITTEN PERMISSION FROM DART AEROSPACE LTD.

04.02.06 2.050 WAS 2.000

